



NPE-Tech - Powerco C25
116 Rifle Range Road,
New Plymouth
New Plymouth

office@npe-tech.co.nz
www.npe-tech.co.nz
Fax :

JOB NO. 1081252

License No.

Done 26-05-2026

POWERCO LTD
POWERCO LTD
35 Junction Street
Welbourn Taranaki 4360

Site: 101 Russell Street,
Palmerston North


Site Contact:

Salesperson:

Date: 20/05/2026



DG Labelling request - 00052550 - ICP 0000006170CP3EC
101 RUSSELL STREET, PALMERSTON NORTH, 4414
WMA 50474259

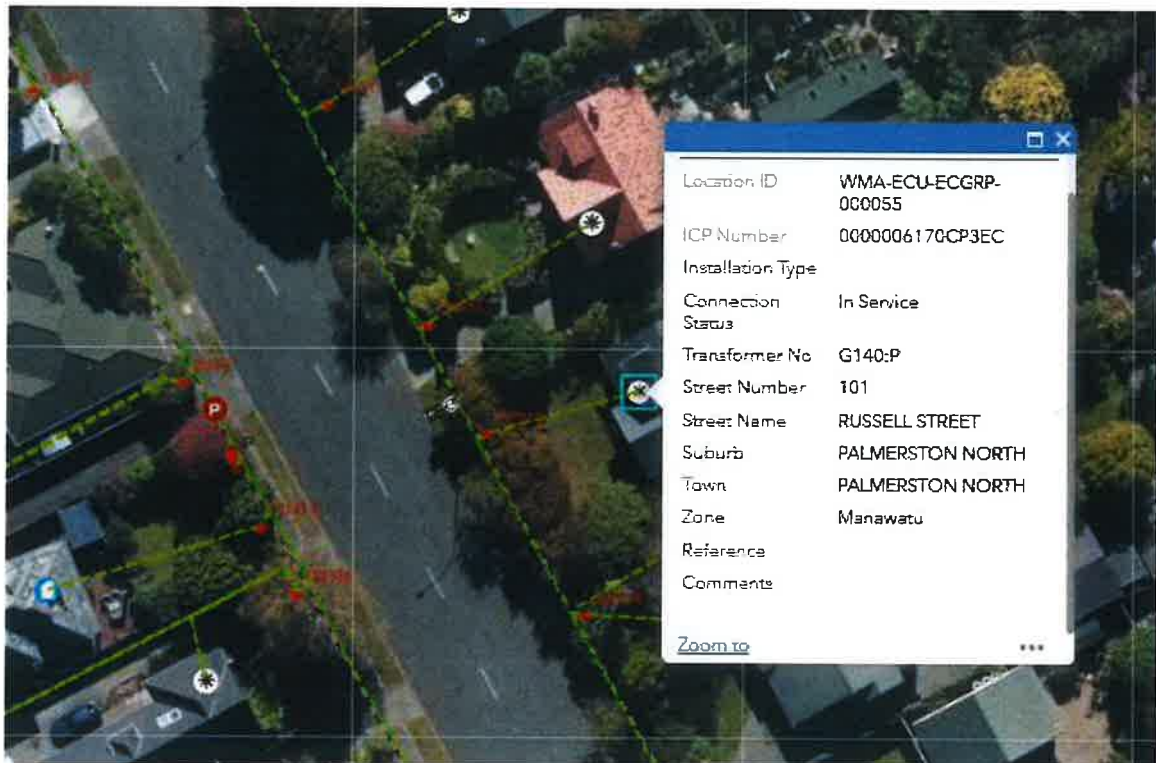

AS-BUILT LOW VOLTAGE CONNECTION RECORD

Physical Address and/or Legal Description (incl. Lot & DP No):

101 Russell St

Contractor: NPE-Tech

Date Work Completed: 26-05-2026

Signed: [Signature]

City/Town: Palmerston North

District: Manawatu

Customer Works Application Number: 50474259

Powerco Workorder Number: 50474259

Cow Shed Number (Dairy Number):

C.O.C Number:

ICP Number: 0000006176CPSEC

PHYSICAL CONNECTION POINT:

Installed service:

Overhead line

☒ Underground cable

Conductor connected to:

☒ Box

Pole

Other (specify)

Pole/Service box number: 121313

CONDUCTOR DETAILS:

Conductor size: 16mm²

Conductor material: Cu

Insulation: 63 & 203

Number of cables: 1

Number of cores: 2

Fuse size (Amps): POC/10

Number of phases: 2

Phase colour(s): R.Y

Cable duct used:

☒ No

New (specify size)


Existing (specify size)

WORK PLAN AND DESCRIPTION:
Location of Conductor

Provide dimensioned plan below. Must include measurements for any change in direction, to any duct end and for any depth outside industry standard. GPS any cables that cannot be easily measured.

Where an LV open point is at the point of connection, show clearly what side the connection has been made to.

Include North arrow in circle.

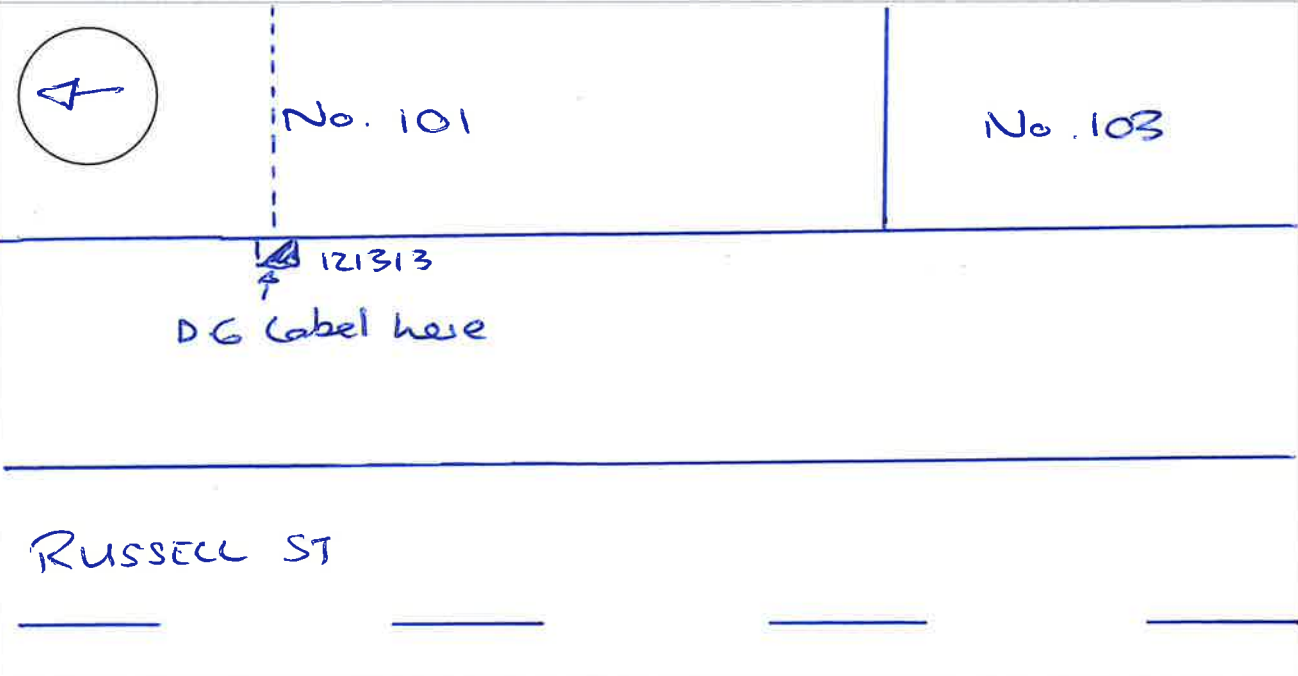

Describe the work performed: