



NPE-Tech - Powerco C25
116 Rifle Range Road,
New Plymouth
New Plymouth

office@npe-tech.co.nz
www.npe-tech.co.nz
Fax :

JOB NO. 1081447

License No.

Done 26-05-2026

POWERCO LTD
POWERCO LTD
35 Junction Street
Welbourn Taranaki 4360

Site: 8 Tawa Street,
Palmerston North


Site Contact:

Salesperson:

Date: 26/05/2026




DG Labelling request - 00051586 - ICP 0000006259CP3EB
8 TAWA STREET, PALMERSTON NORTH, 4414
WMA 50474259

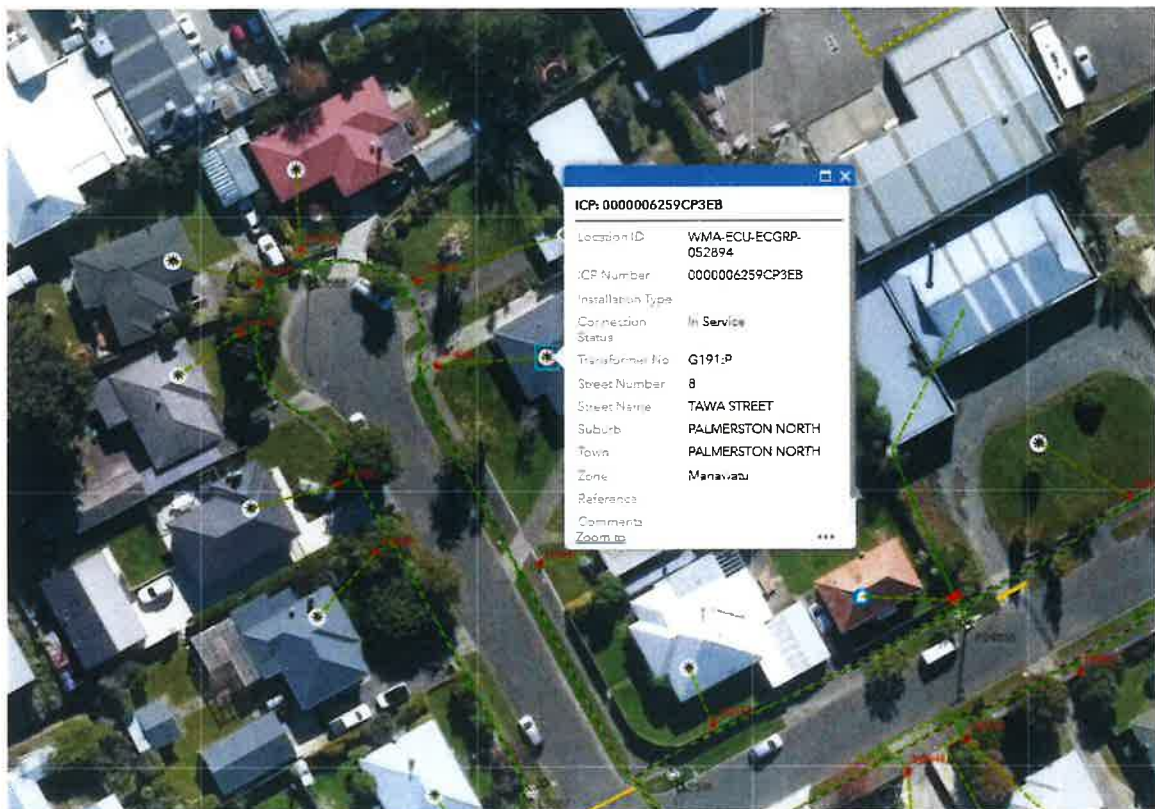

AS-BUILT LOW VOLTAGE CONNECTION RECORD

Physical Address and/or Legal Description (incl. Lot & DP No): 8 Tawa Street	Contractor: NPE Tech Date Work Completed: 26-05-2026 Signed: JOM
City/Town: Palmerston North District: Manawatu Cow Shed Number (Dairy Number): ICP Number: 0000006259CP3EB	Customer Works Application Number: 50474259 Powerco Workorder Number: 50474259 C.O.C Number:

PHYSICAL CONNECTION POINT:			
Installed service:	Overhead line	☒ Underground cable	
Conductor connected to:	☒ Box	Pole	Other (specify)
Pole/Service box number: 114044			
CONDUCTOR DETAILS:			
Conductor size: 16mm ²	Conductor material: Cu	Insulation: POC/NS	
Number of cables: 1	Number of cores: 2	Fuse size (Amps): 63 & 20	
Number of phases: 2	Phase colour(s): R, Y		
Cable duct used:	☒ No	New (specify size)	Existing (specify size)

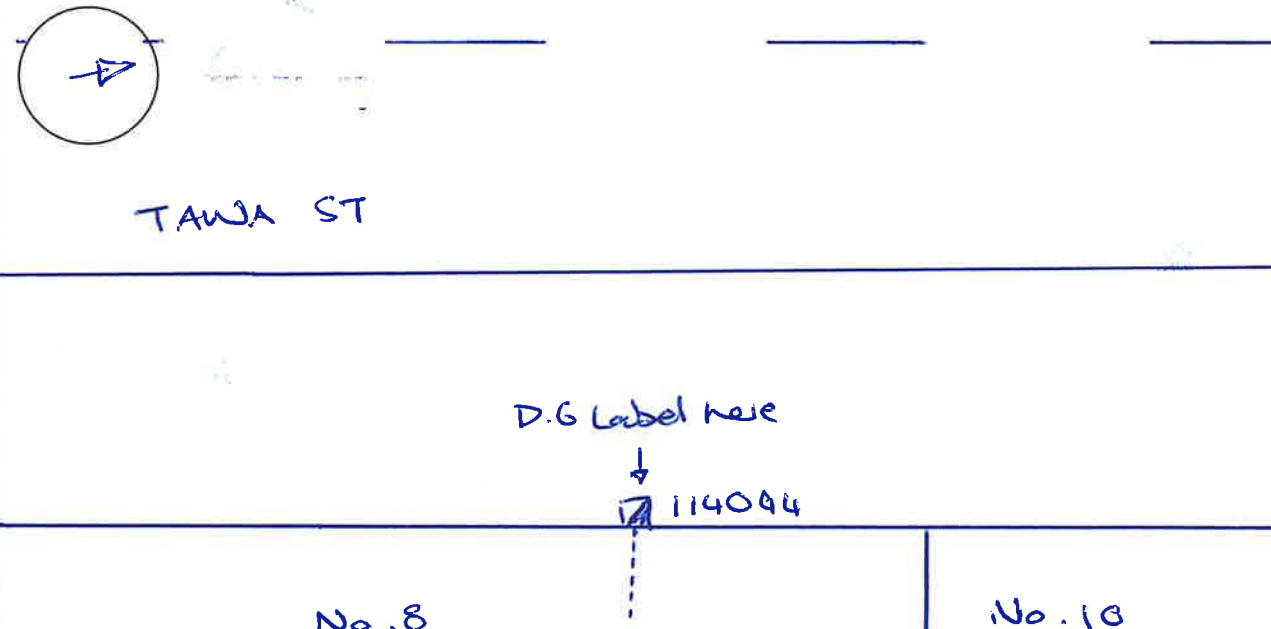WORK PLAN AND DESCRIPTION:	
Location of Conductor Provide dimensioned plan below. Must include measurements for any change in direction, to any duct end and for any depth outside industry standard. GPS any cables that cannot be easily measured. Where an LV open point is at the point of connection, show clearly what side the connection has been made to. Include North arrow in circle.	
	

Describe the work performed: