



NPE-Tech - Powerco C25  
116 Rifle Range Road,  
New Plymouth  
New Plymouth

office@npe-tech.co.nz  
www.npe-tech.co.nz  
Fax :

**JOB NO. 1081247**

License No.

*Done 26-05-2026*

POWERCO LTD  
POWERCO LTD  
35 Junction Street  
Welbourn Taranaki 4360

**Site:** 15 Te Hirawanui Drive,  
Kelvin Grove


**Site Contact:**

**Salesperson:**

**Date:** 20/05/2026



DG Labelling request - 00044792 - ICP 1000616741PCD6B  
**15 Te Hirawanui Drive, Kelvin Grove, Palmerston North, 4414**  
WMA 50474259

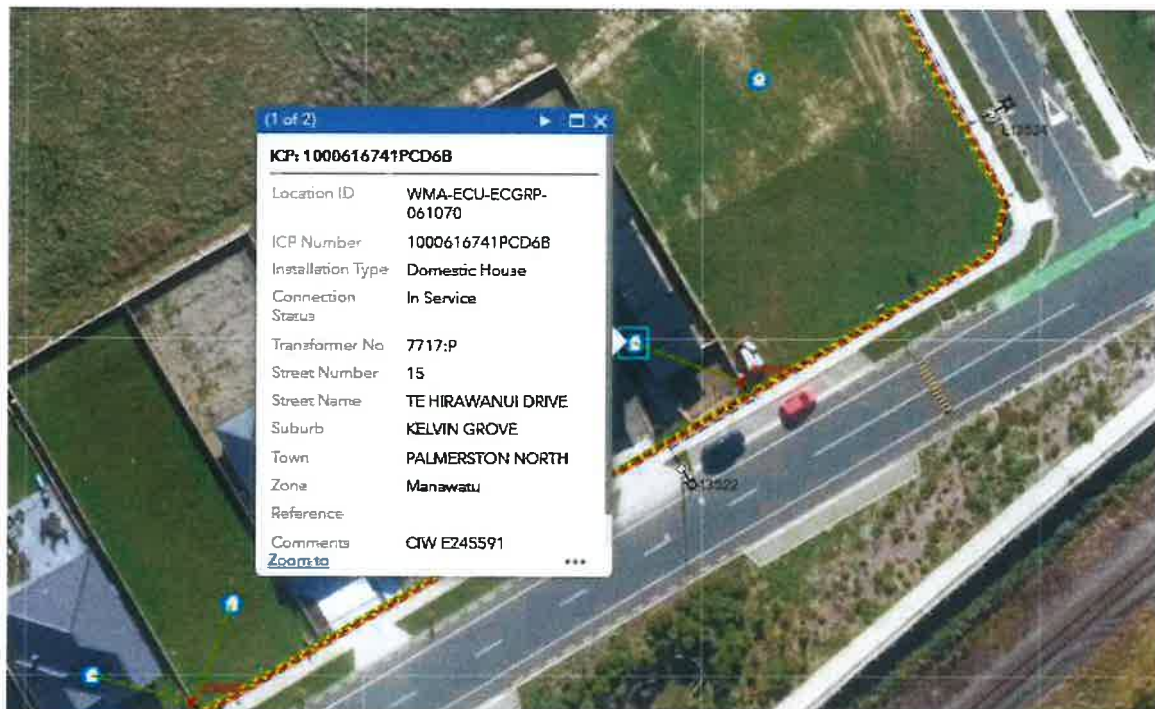

### AS-BUILT LOW VOLTAGE CONNECTION RECORD

|                                                                                                              |                                                                                                     |
|--------------------------------------------------------------------------------------------------------------|-----------------------------------------------------------------------------------------------------|
| Physical Address and/or Legal Description (Incl. Lot & DP No):<br><b>15 Te Hirawanui Drive, Kelvin Grove</b> | Contractor: <b>NPE-Tech</b><br>Date Work Completed: <b>26-05-2026</b><br>Signed: <b>[Signature]</b> |
| City/Town: <b>Palmerston North</b><br>District: <b>Manawatu</b>                                              | Customer Works Application Number: <b>50474259</b><br>Powerco Workorder Number: <b>50474259</b>     |
| Cow Shed Number (Dairy Number):<br>ICP Number: <b>1000616741PCD66</b>                                        | C.O.C Number:                                                                                       |

#### PHYSICAL CONNECTION POINT:

|                          |                                         |                                                       |
|--------------------------|-----------------------------------------|-------------------------------------------------------|
| Installed service:       | <input type="checkbox"/> Overhead line  | <input checked="" type="checkbox"/> Underground cable |
| Conductor connected to:  | <input checked="" type="checkbox"/> Box | <input type="checkbox"/> Pole                         |
| Pole/Service box number: | <b>320953</b>                           |                                                       |


#### CONDUCTOR DETAILS:

|                                         |                                        |                                                  |
|-----------------------------------------|----------------------------------------|--------------------------------------------------|
| Conductor size: <b>16mm<sup>2</sup></b> | Conductor material: <b>Cu</b>          | Insulation: <b>PVC/NS</b>                        |
| Number of cables: <b>1</b>              | Number of cores: <b>1</b>              | Fuse size (Amps): <b>63</b>                      |
| Number of phases: <b>1</b>              | Phase colour(s): <b>Red</b>            |                                                  |
| Cable duct used:                        | <input checked="" type="checkbox"/> No | <input type="checkbox"/> New (specify size)      |
|                                         |                                        | <input type="checkbox"/> Existing (specify size) |

#### WORK PLAN AND DESCRIPTION:

##### Location of Conductor

Provide dimensioned plan below. Must include measurements for any change in direction, to any duct end and for any depth outside industry standard. GPS any cables that cannot be easily measured.  
Where an LV open point is at the point of connection, show clearly what side the connection has been made to.  
Include North arrow in circle.

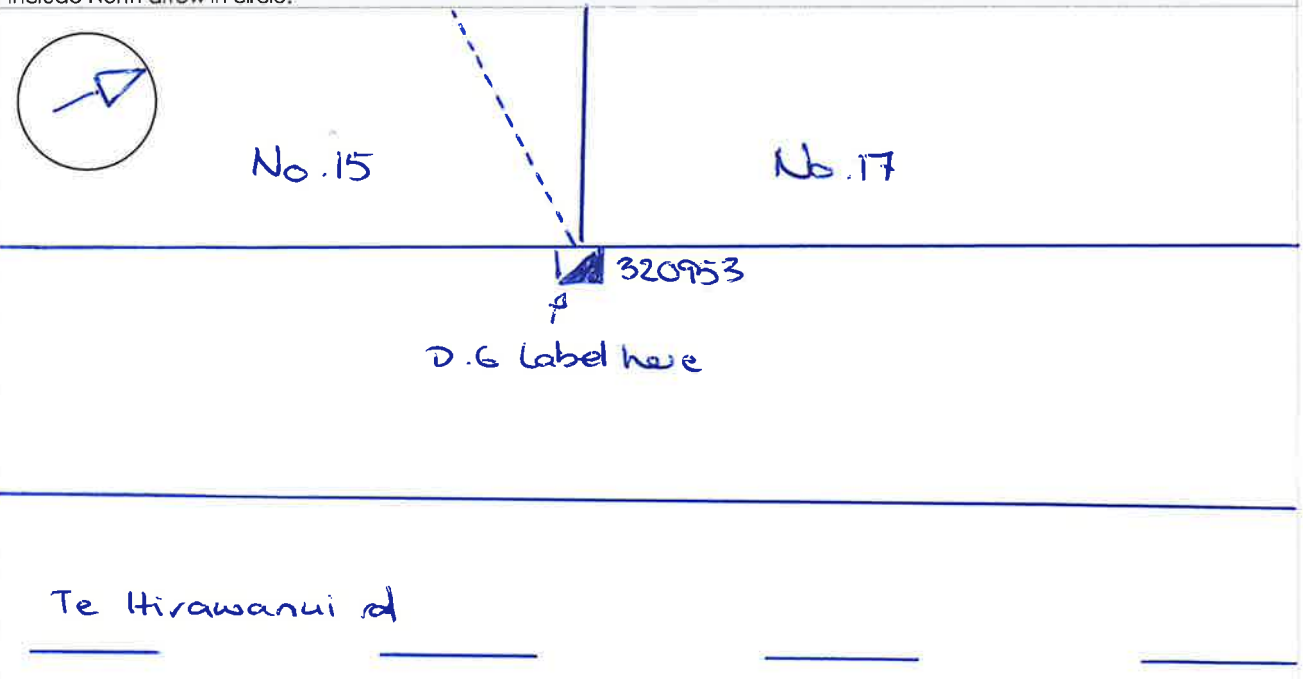

Te Hirawanui rd

#### Describe the work performed: