



NPE-Tech - Powerco C25  
116 Rifle Range Road,  
New Plymouth  
New Plymouth

office@npe-tech.co.nz  
www.npe-tech.co.nz  
Fax :

License No.

*Done 26-05-2026*

**JOB NO. 1081053**

POWERCO LTD  
POWERCO LTD  
35 Junction Street  
Wobourn Taranaki 4360

**Site:** 70 Keeling Street,  
West End


**Site Contact:**

**Salesperson:**

**Date:** 14/05/2026



DG Labelling request - 00051002 - ICP 0000020322CPD6B  
**70 KEELING STREET, WEST END, PALMERSTON NORTH, 4412**  
WMA 50474259

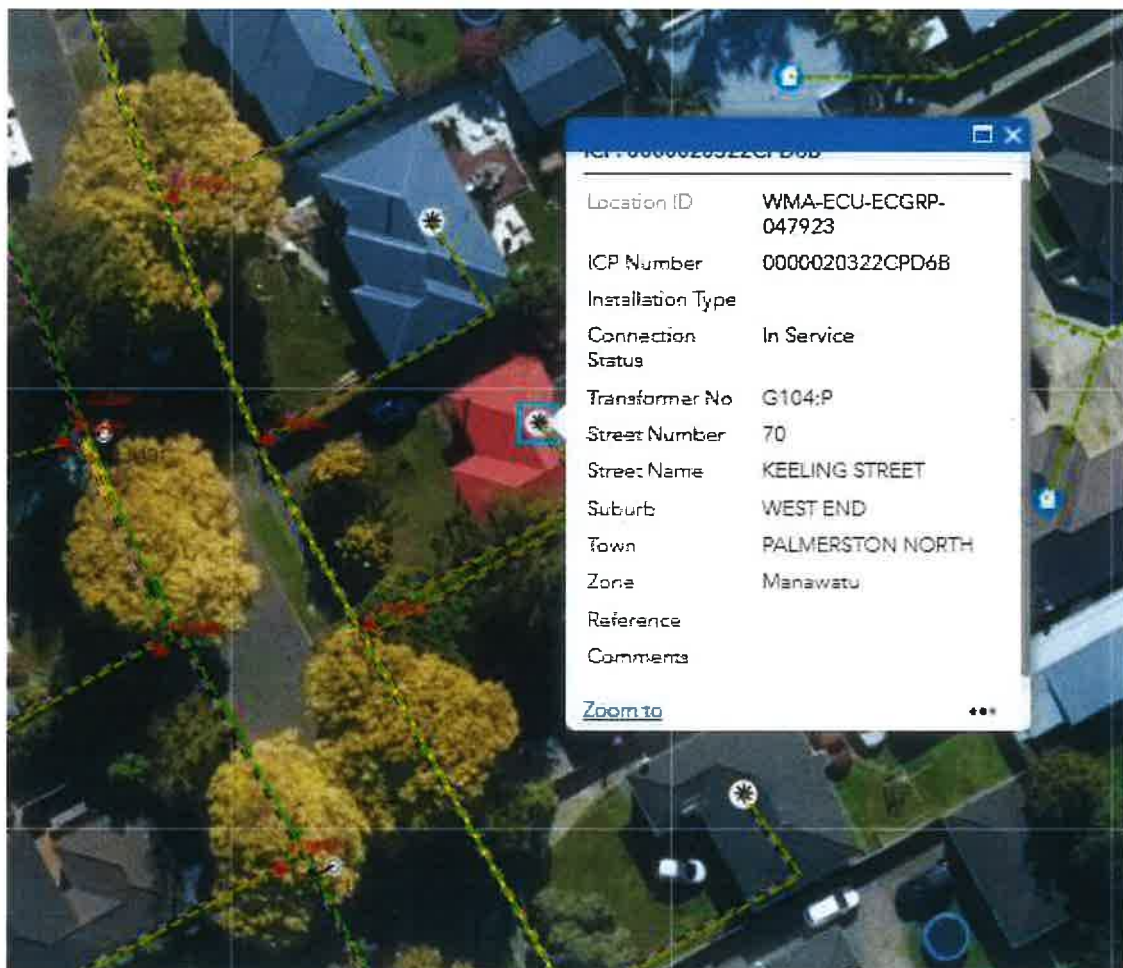

### AS-BUILT LOW VOLTAGE CONNECTION RECORD

Physical Address and/or Legal Description (Incl. Lot &amp; DP No):

70 Keeling Street, Westend

Contractor: NPE-Tech

Date Work Completed: 26-05-2026

Signed: [Signature]

City/Town: Palmerston North

District: Manawatu

Customer Works Application Number: 50474259

Powerco Workorder Number: 50474259

Cow Shed Number (Dairy Number):

C.O.C Number:

ICP Number: 0000020322CPD6B

#### PHYSICAL CONNECTION POINT:

Installed service:

Overhead line

☒ Underground cable

Conductor connected to:

☒ Box

Pole

Other (specify)

Pole/Service box number: 116663

#### CONDUCTOR DETAILS:

Conductor size: 16mm<sup>2</sup>

Conductor material: Cu

Insulation: PVC/NS

Number of cables: 1

Number of cores: 2

Fuse size (Amps): 63 &amp; 20

Number of phases: 2

Phase colour(s): R, W

Cable duct used:

☒ No

New (specify size)

Existing (specify size)


#### WORK PLAN AND DESCRIPTION:

##### Location of Conductor

Provide dimensioned plan below. Must include measurements for any change in direction, to any duct end and for any depth outside industry standard. GPS any cables that cannot be easily measured.

Where an LV open point is at the point of connection, show clearly what side the connection has been made to.

Include North arrow in circle.

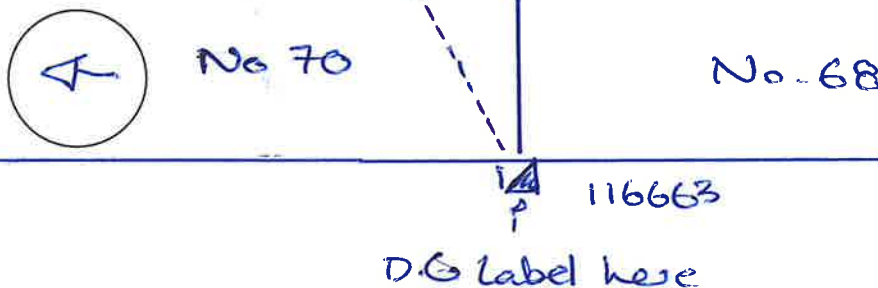

Keeling St

Describe the work performed: